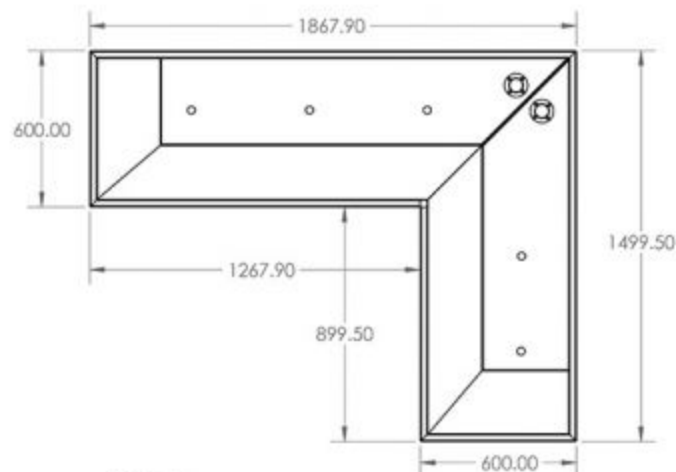
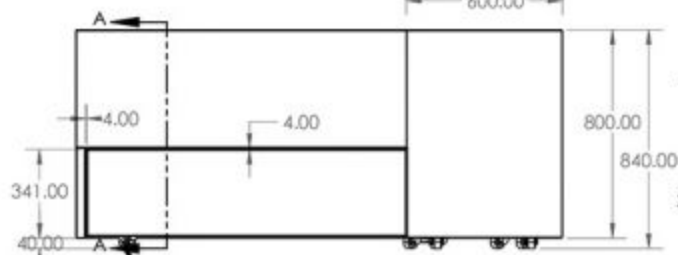


Plan View



Side View

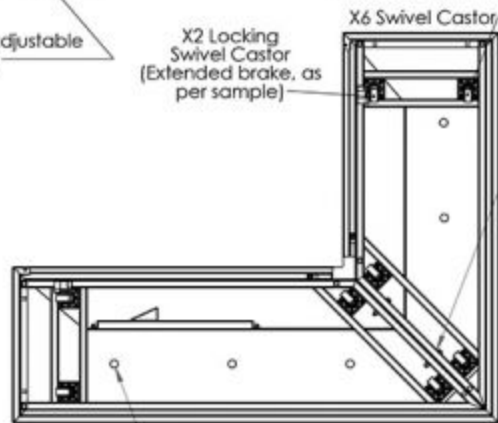


All castors height adjustable range: +40-+70mm

X2 Locking Swivel Castor (Extended brake, as per sample)

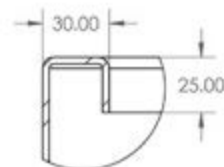
X6 Swivel Castor

Base View

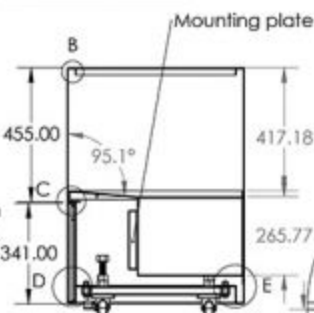
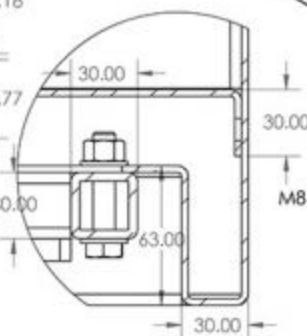


φ 30.00 Drainage holes

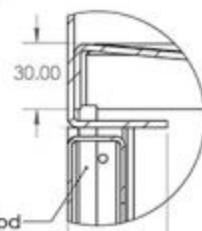
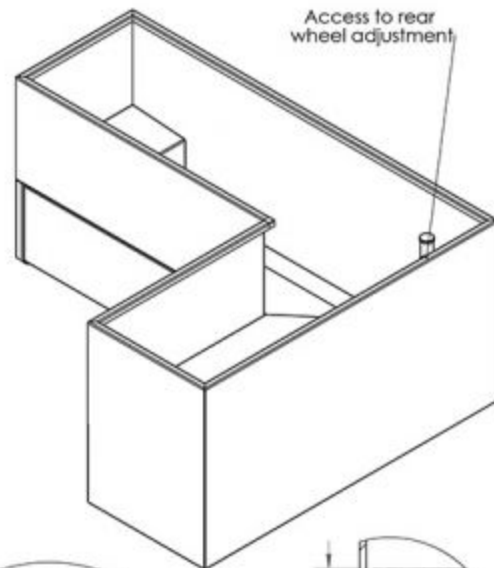
Base frame in 2 separate sections bolted together

DETAIL B
SCALE 1 : 2

AS BUILT
30/01/23

SECTION A-A
SCALE 1 : 15DETAIL E
SCALE 1 : 2

Access to rear wheel adjustment

DETAIL C
SCALE 1 : 2

All raw edges to sheet metal to have radius of 1-2mm (For Bradleys Finish)

			FINISH: Metalite Zinc Age 917 Grade 1		DO NOT SCALE DRAWING		REVISION: 01		
			PART SPEC:		IOTA				
NAME		SIGNATURE		DATE		TITLE: Bloomberg 1867.9 Corner Planter			
DRAWN: GR				12/01/22					
DRAWN: JBB				26/05/22					
CHIEF:									
APPROV:									
MATERIAL: 3mm CR4/ 30 x 30 x 3 SHS (St/St)						DWS NO:		A3	
WEIGHT: 292 Kg						1867.9CP-Assy			
		GPI:		x1		SHEET 1 OF 1			

SHEET 1 OF 2