


Typical section.  
Planter to be continuous  
multi section.

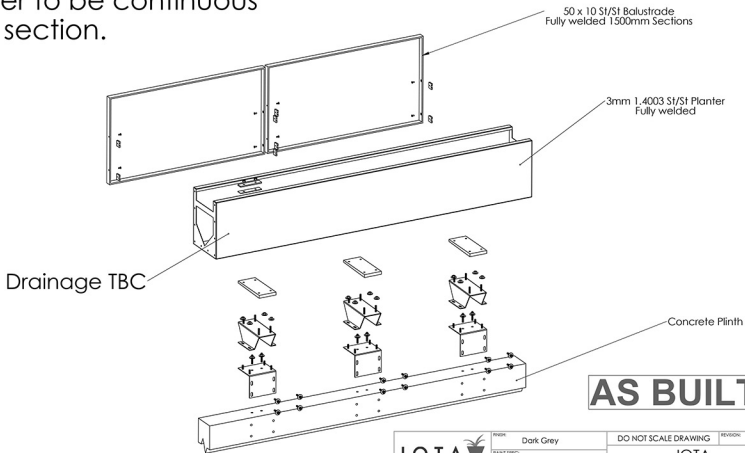

**AS BUILT**

Weight per 3m Section  
including handrail 202KG

		RINK Dark Grey FRAME SPEC IGP DURAXAL 4201 STYLE 31	DO NOT SCALE DRAWING REVISION 4
DRAWN: QJR CHK'D: APP'VD:	NAME: [ ] SIGNATURE: [ ] DATE: 28/04/21	UNLESS OTHERWISE SPECIFIED: DIMENSIONS ARE IN MILLIMETERS TOLERANCES: LINEAR: ±0.10mm PER 100mm ANGULAR: ±1.1°	IOTA TITLE: Eastbourne Terrace
MFG: [ ] QTY: [ ]	MATERIAL: [ ] WEIGHT: Kg	DWG NO: L6-3000 Mid Sect	A3 SHEET 1 OF 3