AS BUILT

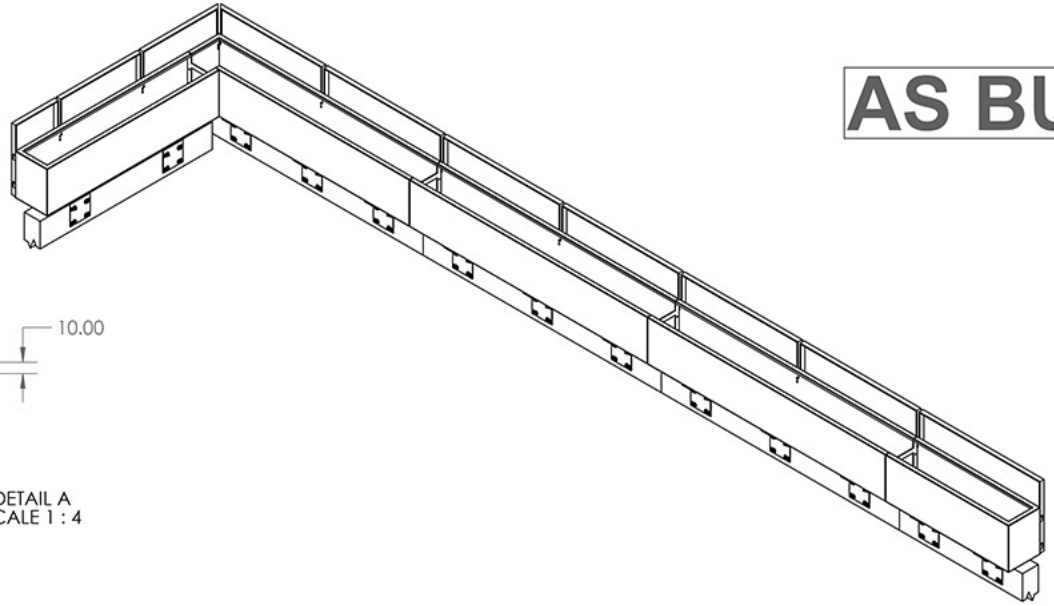

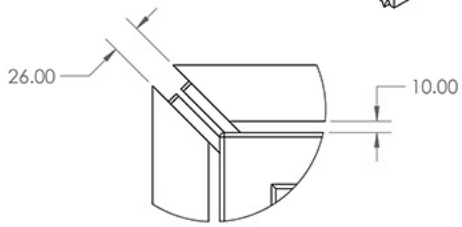

DETAIL A
SCALE 1 : 4

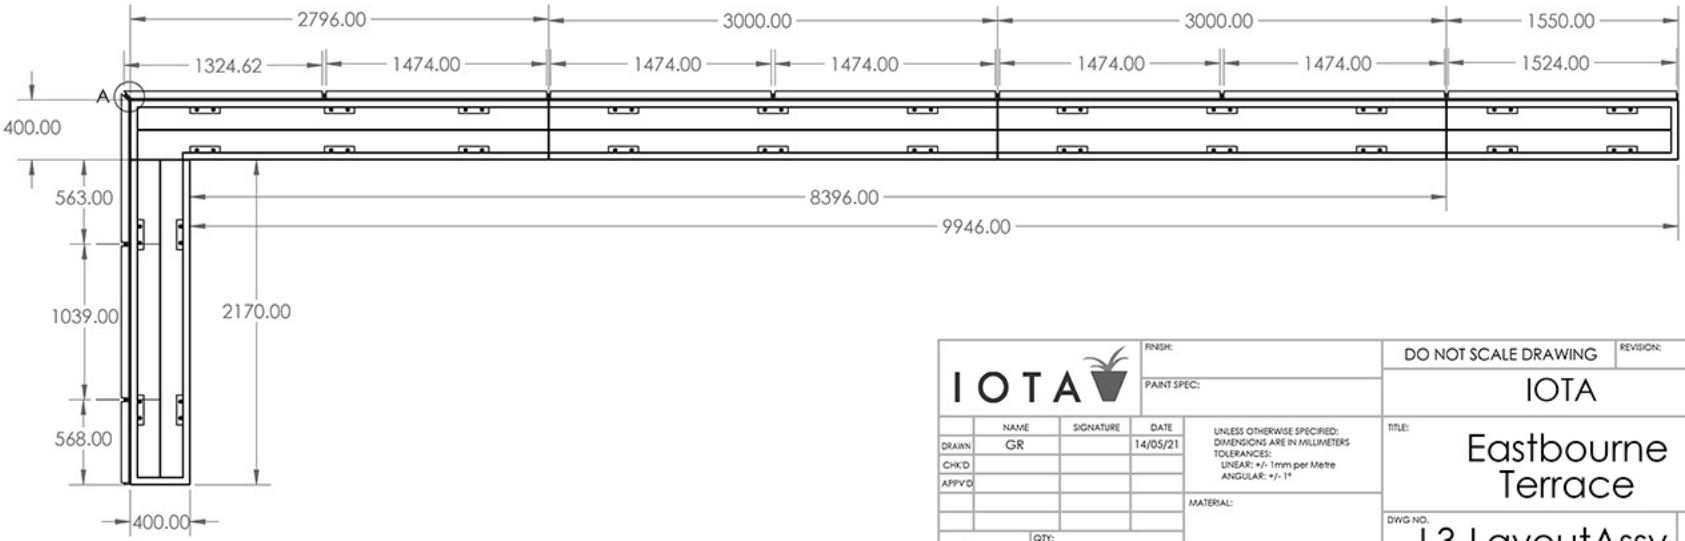

IOTA	FINISH:	DO NOT SCALE DRAWING	REVISION: 5
	PAINT SPEC:	IOTA	
	NAME / SIGNATURE / DATE	UNLESS OTHERWISE SPECIFIED: DIMENSIONS ARE IN MILLIMETERS TOLERANCES: LINEAR: +/- 1mm per Metre ANGULAR: +/- 1°	TITLE: Eastbourne Terrace
DRAWN	GR / 14/05/21		
CHK'D			
APP'V'D			
		MATERIAL:	DWG NO. L3-LayoutAssy
	QTY:	WEIGHT: Kg	A3
			SHEET 1 OF 2